


PROFILE

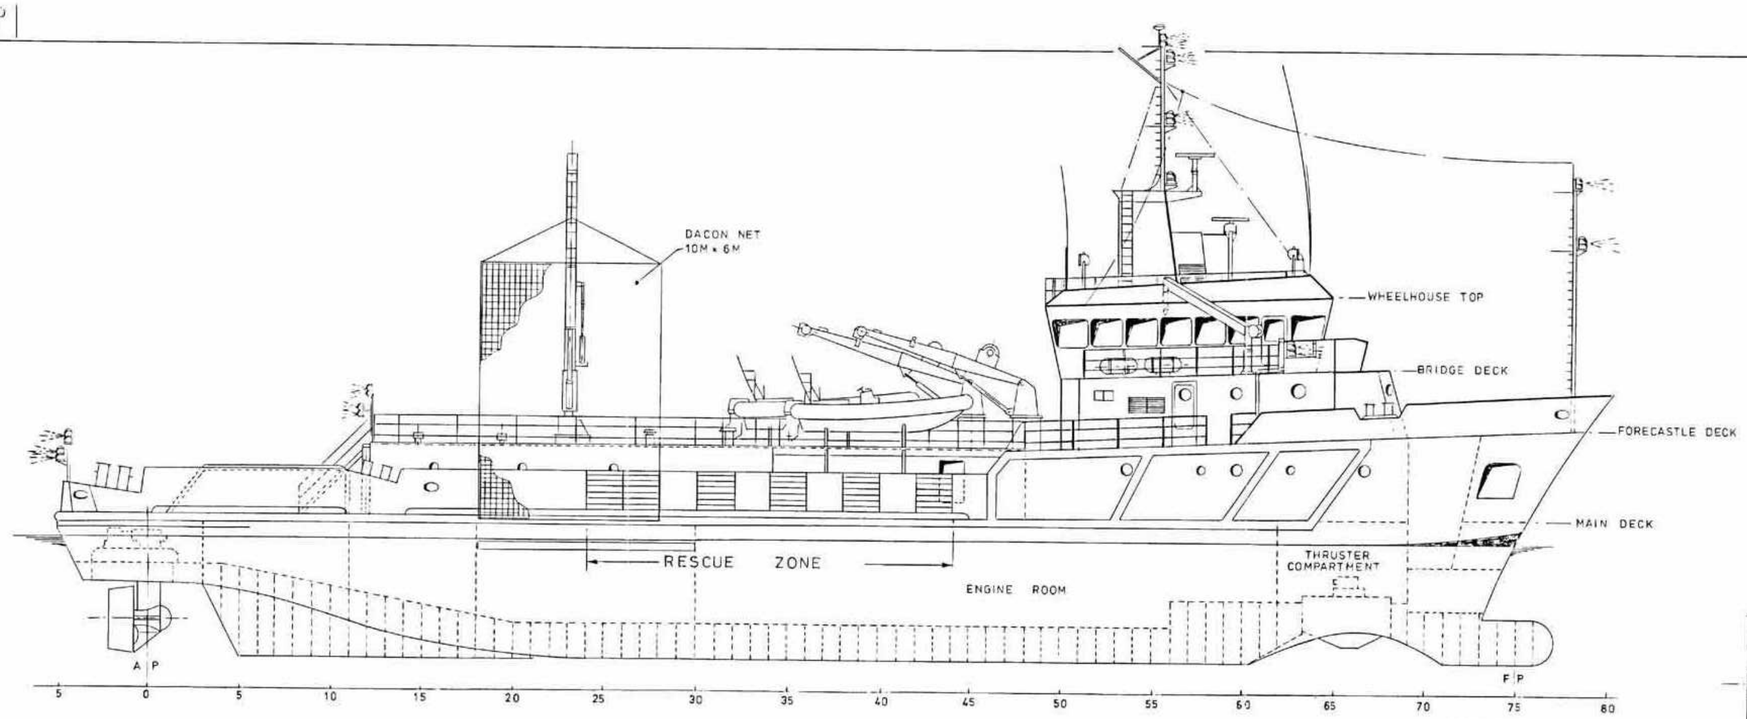


SECTION LOOKING AFT




WHEELHOUSE TOP

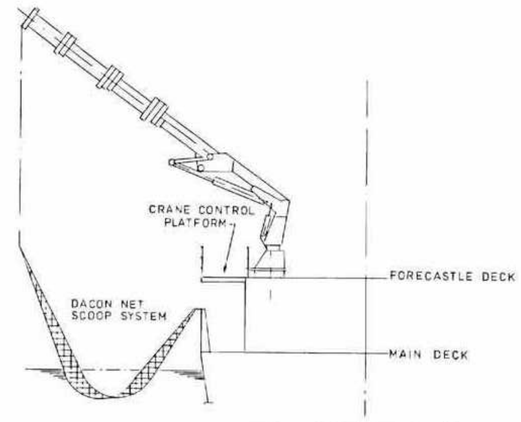


FORECASTLE DECK

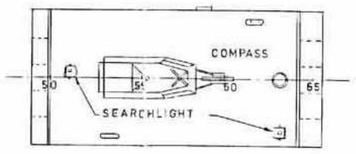


BRIDGE DECK

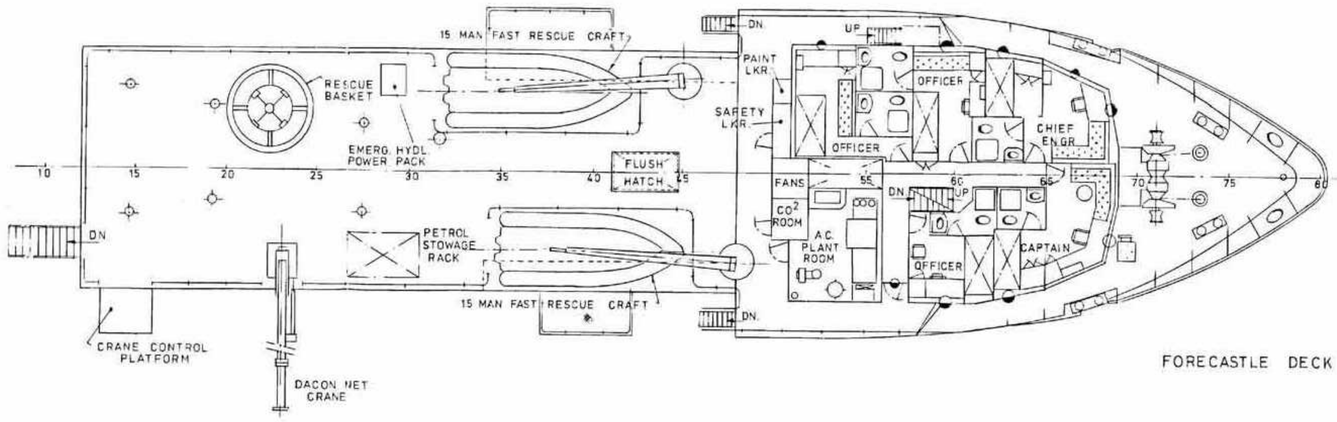


MAIN DECK

PRINCIPAL DIMENSIONS:
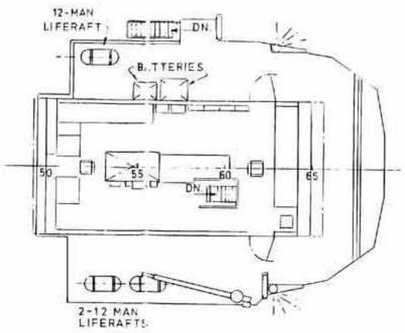
| | |
|---|---|
| LENGTH O.A. | 52·00 M |
| LENGTH B.P. | 45·75 M |
| BREADTH MLD. | 11·00 M |
| DEPTH MLD. | 4·70 M |
| DRAFT | 4·14 M |

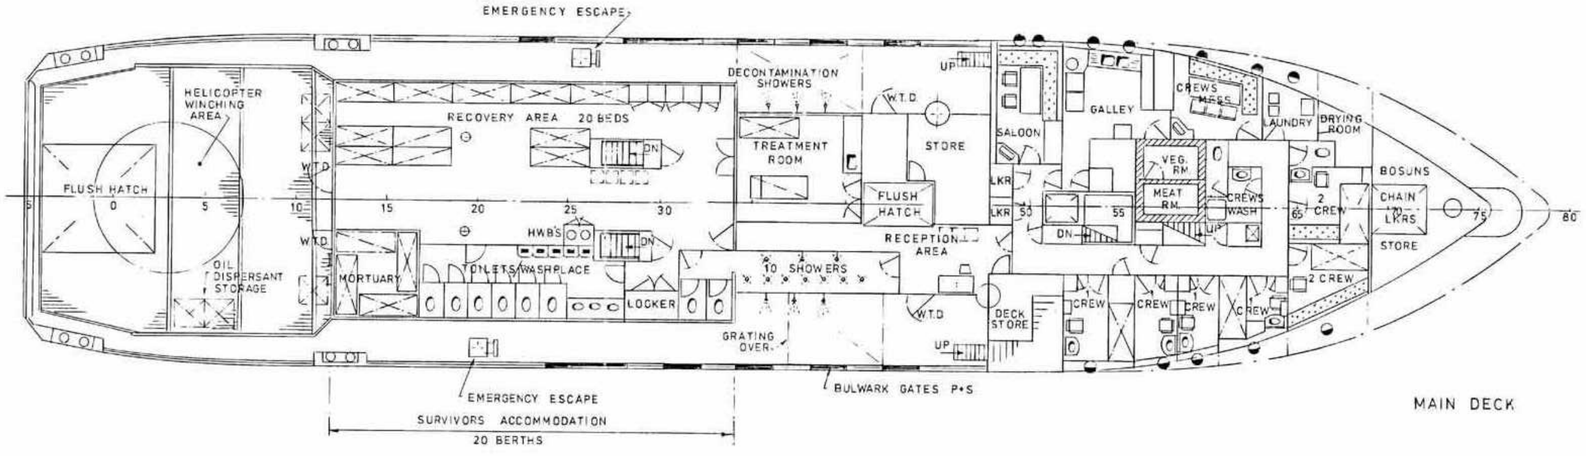


TANK TOP

| REV. | DESCRIPTION | DATE |
|---|---|---|
| B | DACON SCOOP SYSTEM; PAINT LOCKER AND NEW LADDER ADDED – LIFERAFTS RELOCATED | FEB 94 |
| A | DRAWING MODIFIED TO SUIT 'AS BUILT' | FEB 93 |

PREPARED BY: RMR TECHNICAL SERVICES

SHIP: M.V. 'GRAMPIAN SPRITE

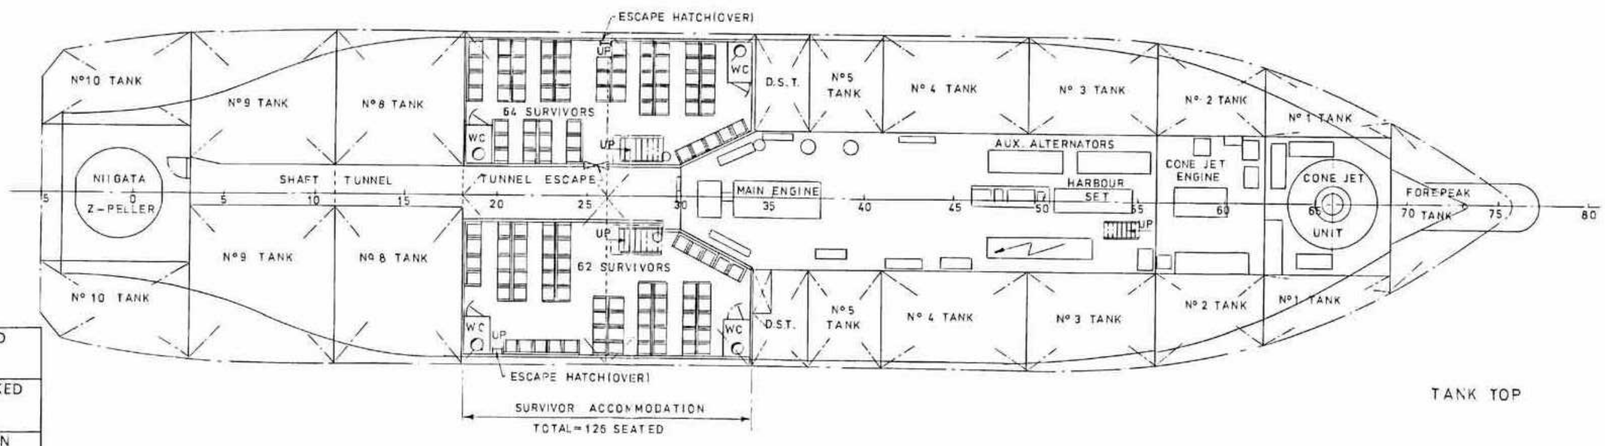TITLE: GENERAL ARRANGEMENT

CLIENT: NORTH STAR SHIPPING — REV. Nº B

DATE: MAY 1992 — DRG. Nº RMR-020

DIMENSIONS IN MILLIMETRES — SCALE 1:100

CERT'D

CHECKED

DRAWN